




UPPER DECK

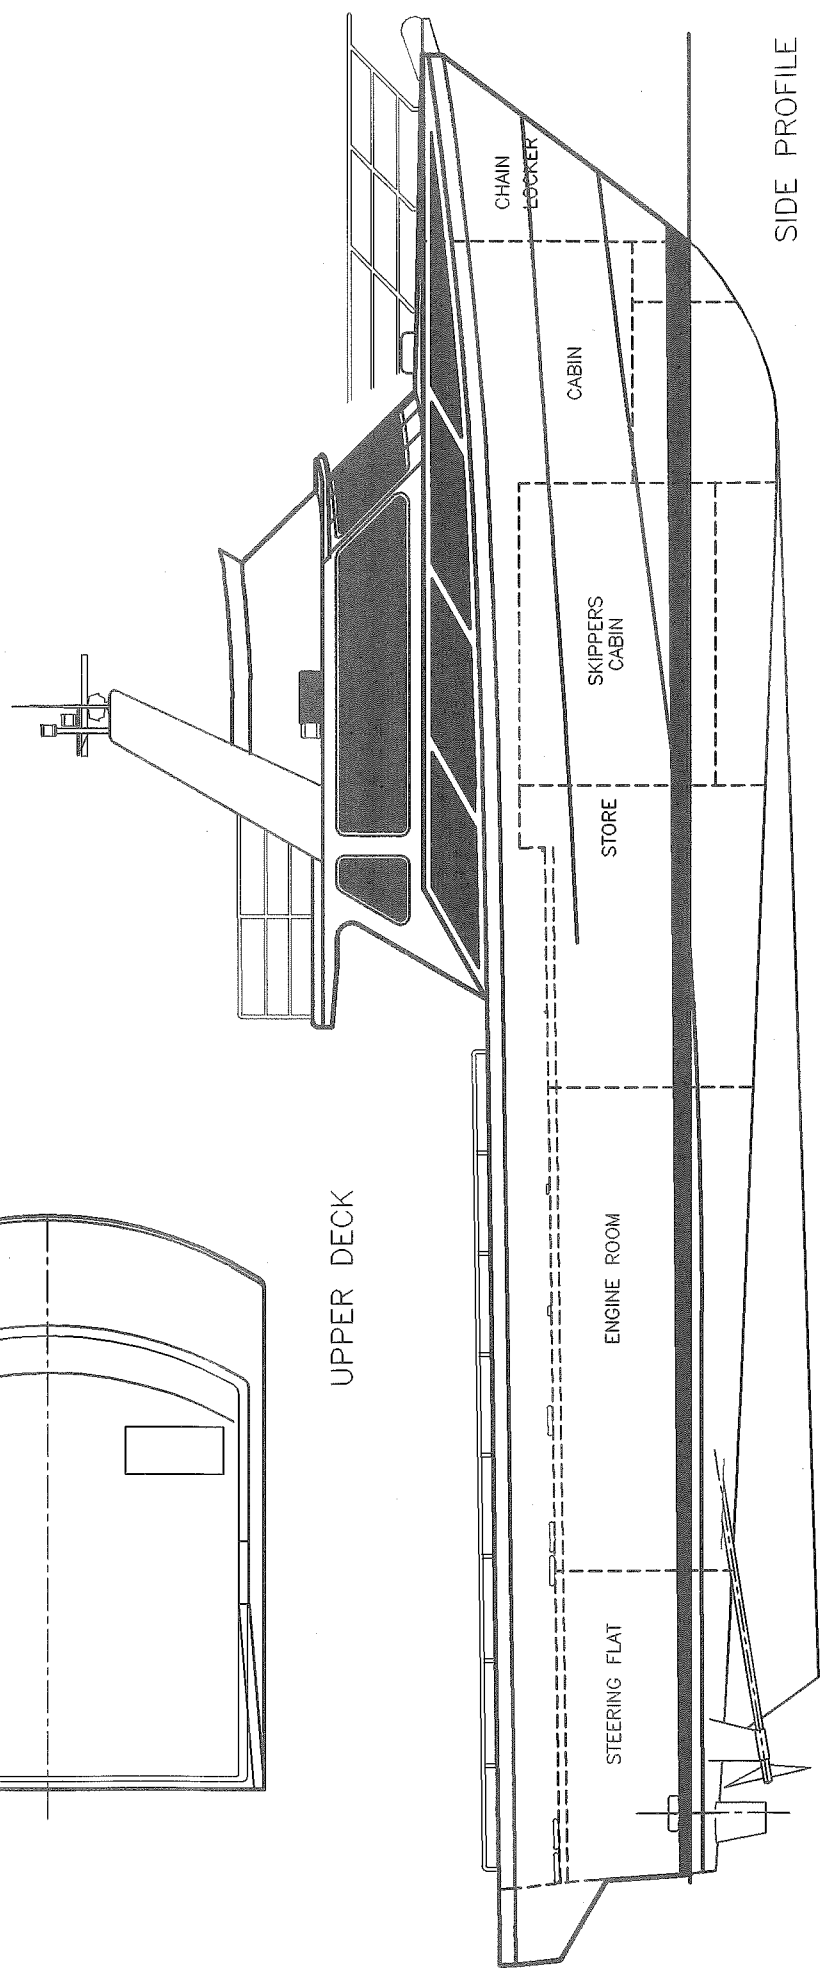


SIDE PROFILE

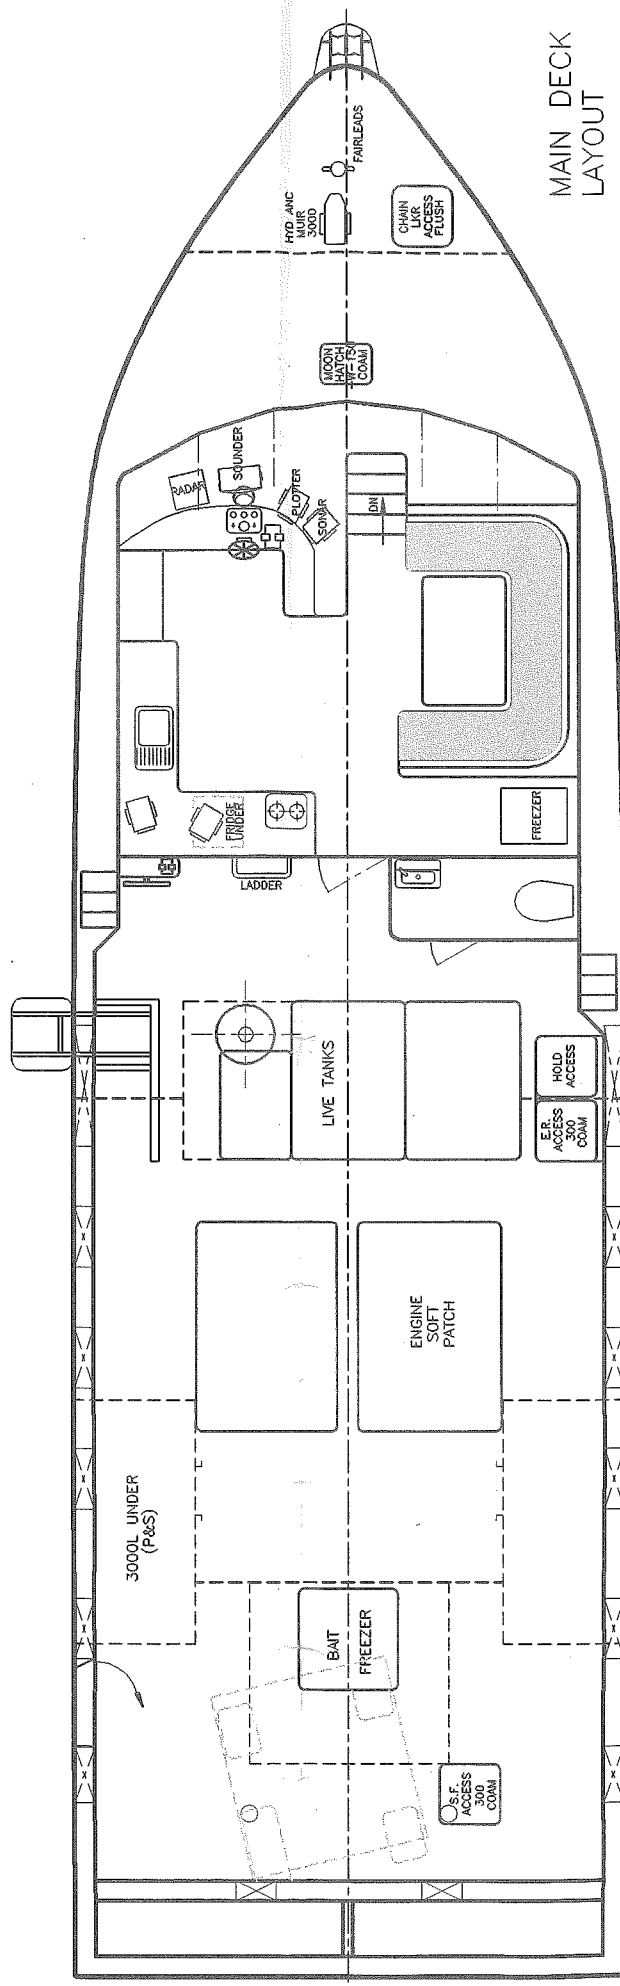

MAIN DECK LAYOUT

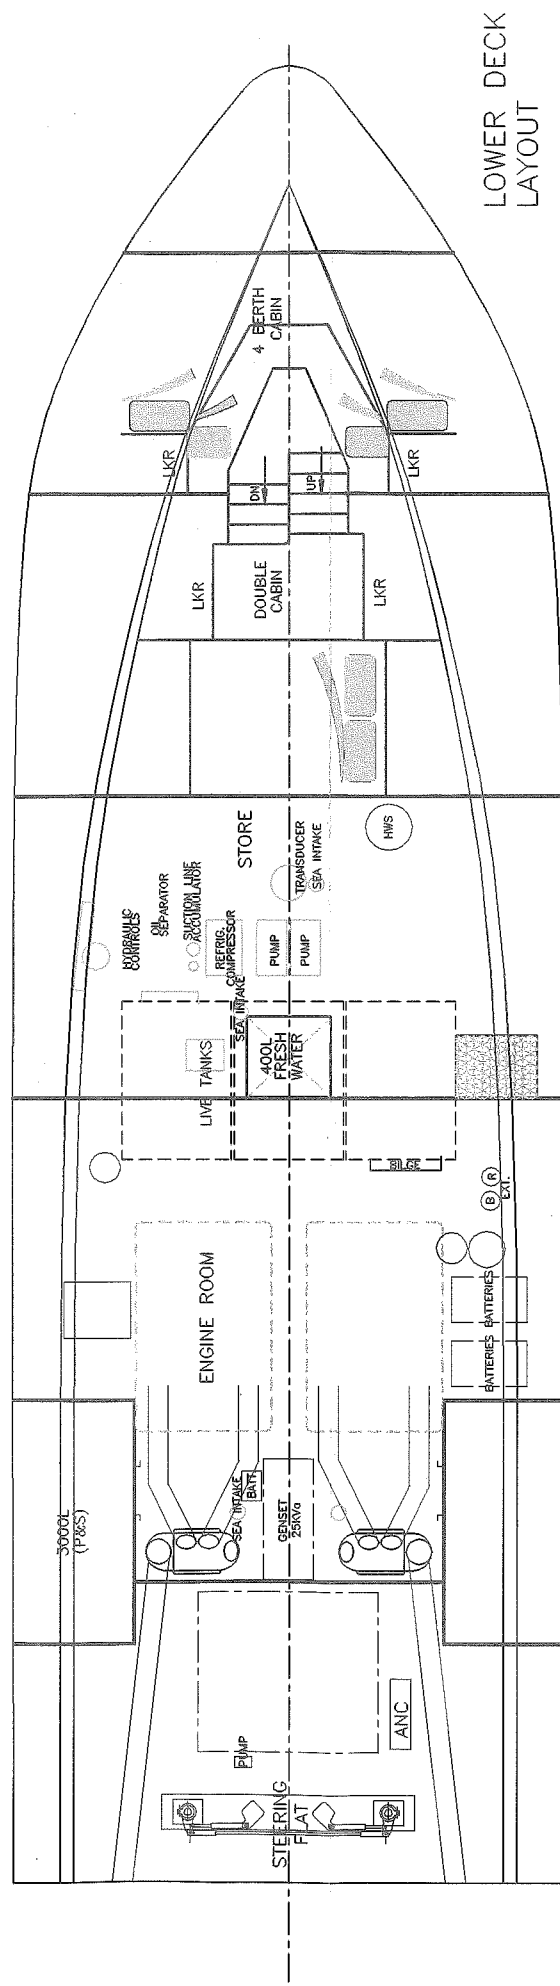

LOWER DECK LAYOUT

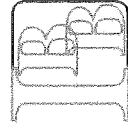

Gordon Blaauw Designs

CLIENT: RETSIS
 PROJECT: 18.3m VESSEL
 SCALE: 1:75
 DATE: JANUARY 1996
 DRAWING NO: IBB158

GENERAL ARRANGEMENT
 AS BUILT AS AT 4 OCTOBER 1996